



2070801956

Page: 1 of 2
8/13/2007 10:14 AM
SPLT \$106.00
Whatcom County, WA

Request of: RONALD JEPSON

SHORT PLAT

NUMBER OF SHEETS 2

NAME OF SHORT PLAT:

Douglas Road Lot Line Adjustment

DECLARANTS:

South Douglas LLC
Douglas Place LLC

SURVEYOR:

Ronald T. Jepsom & Assoc.

SECTION: 30 TOWNSHIP: 39N RANGE: 2E

2070801956

DOUGLAS ROAD LOT LINE ADJUSTMENT

A PORTION OF THE WEST 1/2 OF THE NW 1/4 OF SECTION 30 TOWNSHIP 39 NORTH, RANGE 2E OF W.M.
CITY OF FERNDAL, WHATCOM COUNTY, WASHINGTON

DECLARATION

WE THE UNDERSIGNED OWNERS OF THE LOTS DEPICTED HEREON HEREBY DECLARE THIS LOT LINE ADJUSTMENT IS MADE WITH OUR FREE CONSENT AND IN ACCORDANCE WITH OUR WISHES, AND THAT THE LEGAL DOCUMENTS NECESSARY TO TRANSFER TITLE TO THE PROPERTY HAS BEEN PREPARED AND EXECUTED SO THAT UPON RECORDING OF THIS LOT LINE ADJUSTMENT, THE TITLE TO THE PROPERTIES WILL ACCURATELY REFLECT THE NEW CONFIGURATION RESULTING FROM THE LOT LINE ADJUSTMENT, AS APPROVED BY THE CITY.

William E. Kramer
SOUTH DOUGLAS LLC, , MANAGING PARTNER

Douglas S. Marr
DOUGLAS PLACE LLC, DOUGLAS MARR, MANAGING PARTNER

LEGAL DESCRIPTION

LEGAL DESCRIPTION OF NEW PARCEL "A"

THAT PORTION OF THE WEST HALF OF THE NORTHWEST QUARTER OF SECTION 30, TOWNSHIP 39 NORTH, RANGE 2 EAST OF W.M., WHATCOM COUNTY, WASHINGTON, DESCRIBED AS FOLLOWS: COMMENCING AT THE SOUTHWEST CORNER OF SAID NORTHWEST QUARTER OF SECTION 30; THENCE NORTH 01°45'55" WEST ALONG THE WEST LINE OF SAID SUBDIVISION A DISTANCE OF 1980.00 FEET; THENCE NORTH 87°41'30" EAST PARALLEL TO THE SOUTH LINE OF SAID NORTHWEST QUARTER A DISTANCE OF 437.02 FEET TO THE POINT OF BEGINNING; THENCE CONTINUING NORTH 87°41'30" EAST, 222.98 FEET; THENCE SOUTH 01°45'55" EAST, 1274.03 FEET MORE OR LESS TO THE NORTHERLY RIGHT-OF-WAY OF DOUGLAS ROAD; THENCE SOUTH 53°44'32" WEST ALONG SAID NORTHERLY RIGHT-OF-WAY LINE 300.00 FEET; THENCE LEAVING SAID RIGHT-OF-WAY NORTH 01°45'55" WEST, 13.45 FEET; THENCE NORTH 54°37'38" EAST, 33.68 FEET; THENCE NORTH 36°03'33" WEST, 108.12 FEET; THENCE NORTH 54°27'47" EAST, 78.05 FEET; THENCE NORTH 35°32'13" WEST, 100.00 FEET; THENCE NORTH 54°27'47" EAST, 28.36 FEET; THENCE NORTH 01°45'55" WEST, 677.82 FEET; THENCE NORTH 00°51'54" WEST, 400.16 FEET; THENCE NORTH 87°41'30" EAST, 18.00 FEET; THENCE NORTH 01°45'55" WEST, 100.00 FEET TO THE TRUE POINT OF BEGINNING.

LEGAL DESCRIPTION OF NEW PARCEL "B"

THAT PORTION OF THE WEST HALF OF THE NORTHWEST QUARTER OF SECTION 30, TOWNSHIP 39 NORTH, RANGE 2 EAST OF W.M., WHATCOM COUNTY, WASHINGTON, DESCRIBED AS FOLLOWS:

COMMENCING AT THE SOUTHWEST CORNER OF THE SAID NORTHWEST QUARTER OF SECTION 30; THENCE NORTH 01°45'55" WEST ALONG THE WEST LINE OF SAID SUBDIVISION A DISTANCE OF 1980.00 FEET TO THE POINT OF BEGINNING; THENCE NORTH 87°41'30" EAST PARALLEL TO THE SOUTH LINE OF SAID NORTHWEST QUARTER A DISTANCE OF 437.02 FEET; THENCE SOUTH 01°45'55" EAST, 100.00 FEET; THENCE SOUTH 87°41'30" WEST, 18.00 FEET; THENCE SOUTH 00°51'54" EAST, 400.16 FEET; THENCE SOUTH 01°45'55" EAST, 677.82 FEET; THENCE SOUTH 54°27'47" WEST, 28.36 FEET; THENCE SOUTH 35°32'13" EAST, 100.00 FEET; THENCE SOUTH 54°27'47" WEST, 78.05 FEET; THENCE SOUTH 36°03'33" EAST, 108.12 FEET; THENCE SOUTH 54°37'28" WEST, 33.68 FEET; THENCE SOUTH 01°45'55" EAST, 13.45 FEET MORE OR LESS TO THE NORTHERLY RIGHT-OF-WAY OF DOUGLAS ROAD; THENCE SOUTH 53°44'32" WEST ALONG SAID NORTHERLY RIGHT-OF-WAY 12.98 FEET; THENCE SOUTH 58°21'25" WEST ALONG SAID RIGHT-OF-WAY 167.86 FEET; THENCE SOUTH 61°12'40" WEST, 236.84 FEET TO A POINT OF CURVATURE ON SAID NORTHERLY RIGHT-OF-WAY; THENCE ALONG A CURVE TO THE LEFT HAVING A RADIUS OF 120.00 FEET THROUGH A CENTRAL ANGLE OF 29°25'09" FOR AN ARC LENGTH OF 61.62 FEET; THENCE LEAVING SAID NORTHERLY RIGHT-OF-WAY OF DOUGLAS ROAD NORTH 01°45'55" WEST A DISTANCE OF 1676.81 FEET TO THE POINT OF BEGINNING.

ACKNOWLEDGMENT

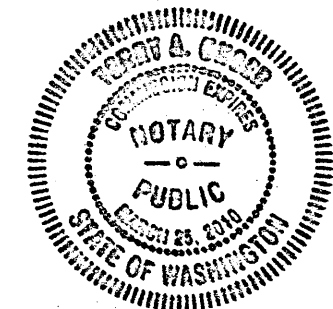
STATE OF WASHINGTON)

COUNTY OF WHATCOM) ss

ON THIS 19th DAY OF July 2007, BEFORE ME THE UNDERSIGNED,

A NOTARY PUBLIC, PERSONALLY APPEARED DOUGLAS MARR, MANAGING PARTNER OF DOUGLAS PLACE LLC TO ME KNOWN TO BE THE INDIVIDUAL DESCRIBED IN AND WHO EXECUTED THE DECLARATION HEREIN, AND ACKNOWLEDGED THAT HE SIGNED AND SEALED THE SAME AS HIS FREE AND VOLUNTARY ACT AND DEED FOR THE USES AND PURPOSES THEREIN MENTIONED. WITNESS MY HAND AND OFFICIAL SEAL THE DAY AND YEAR FIRST ABOVE WRITTEN.

Terry A. Vinger
NOTARY PUBLIC IN AND FOR THE STATE OF WASHINGTON,
RESIDING AT Bellingham



ACKNOWLEDGMENT

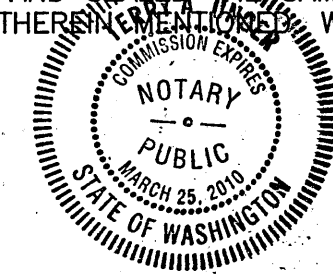
STATE OF WASHINGTON)

COUNTY OF WHATCOM) ss

ON THIS 26 DAY OF July 2007, BEFORE ME THE UNDERSIGNED,

A NOTARY PUBLIC, PERSONALLY APPEARED William E. Kramer MANAGING PARTNER OF SOUTH DOUGLAS LLC TO ME KNOWN TO BE THE INDIVIDUAL DESCRIBED IN AND WHO EXECUTED THE DECLARATION HEREIN, AND ACKNOWLEDGED THAT HE SIGNED AND SEALED THE SAME AS HIS FREE AND VOLUNTARY ACT AND DEED FOR THE USES AND PURPOSES THEREIN MENTIONED. WITNESS MY HAND AND OFFICIAL SEAL THE DAY AND YEAR FIRST ABOVE WRITTEN.

Terry A. Vinger
NOTARY PUBLIC IN AND FOR THE STATE OF WASHINGTON,
RESIDING AT Bellingham



CITY OF FERNDAL APPROVALS

EXAMINED BY FERNDAL CITY CLERK THIS 3rd DAY OF AUGUST, 2007.

Linda Brutsen
FERNDAL CITY CLERK

EXAMINED AND APPROVED BY FERNDAL SHORT PLAT ADMINISTRATOR THIS 9th DAY OF AUGUST, 2007.

Dennis D. Rhoden
FERNDAL SHORT PLAT ADMINISTRATOR

EXAMINED AND APPROVED BY CITY OF FERNDAL PUBLIC WORKS DIRECTOR THIS 6th DAY OF AUGUST, 2007.

Robert Guba
FERNDAL DIRECTOR OF PUBLIC WORKS

SHEET 1 OF 2

JOB # 05055

RECORDING CERTIFICATE

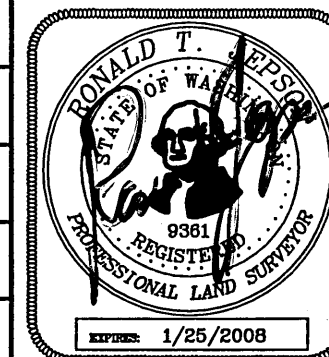
FILED FOR RECORD THIS 13th DAY OF August
2007 AT 10:14 A.M. UNDER AF# 2070801956
AT THE REQUEST OF Ronald T. Jepson

Shirley Foster WHATCOM COUNTY AUDITOR
Quinn J. He DEPUTY COUNTY AUDITOR

SURVEYOR'S CERTIFICATE

THIS MAP CORRECTLY REPRESENTS A SURVEY MADE
BY ME OR UNDER MY DIRECTION IN CONFORMANCE
WITH THE REQUIREMENTS OF THE SURVEY RECORDING
ACT AT THE REQUEST OF William E. Kramer

IN May, 2007.
Ronald T. Jepson CERTIFICATE NO. 9361
RONALD T. JEPSON, P.E., L.S.

Scale
AS SHOWNDrawn by
B.J.H.DATE
05/15/07CHECKED BY
T.A.U.APP'D
R.T.J.

SEC. 30 ,TWP. 39, N., RNG. 2E., W.M.

RONALD T. JEPSON & ASSOCIATES

CONSULTING ENGINEERS • LAND SURVEYORS • PROJECT MGMT. & DEV.
222 GRAND AVE. SUITE 'C', PH. * 360.733.5760, FAX * 360.641.8939,
E-MAIL JEPSON222@AOL.COM, BELLINGHAM, WASHINGTON 98225

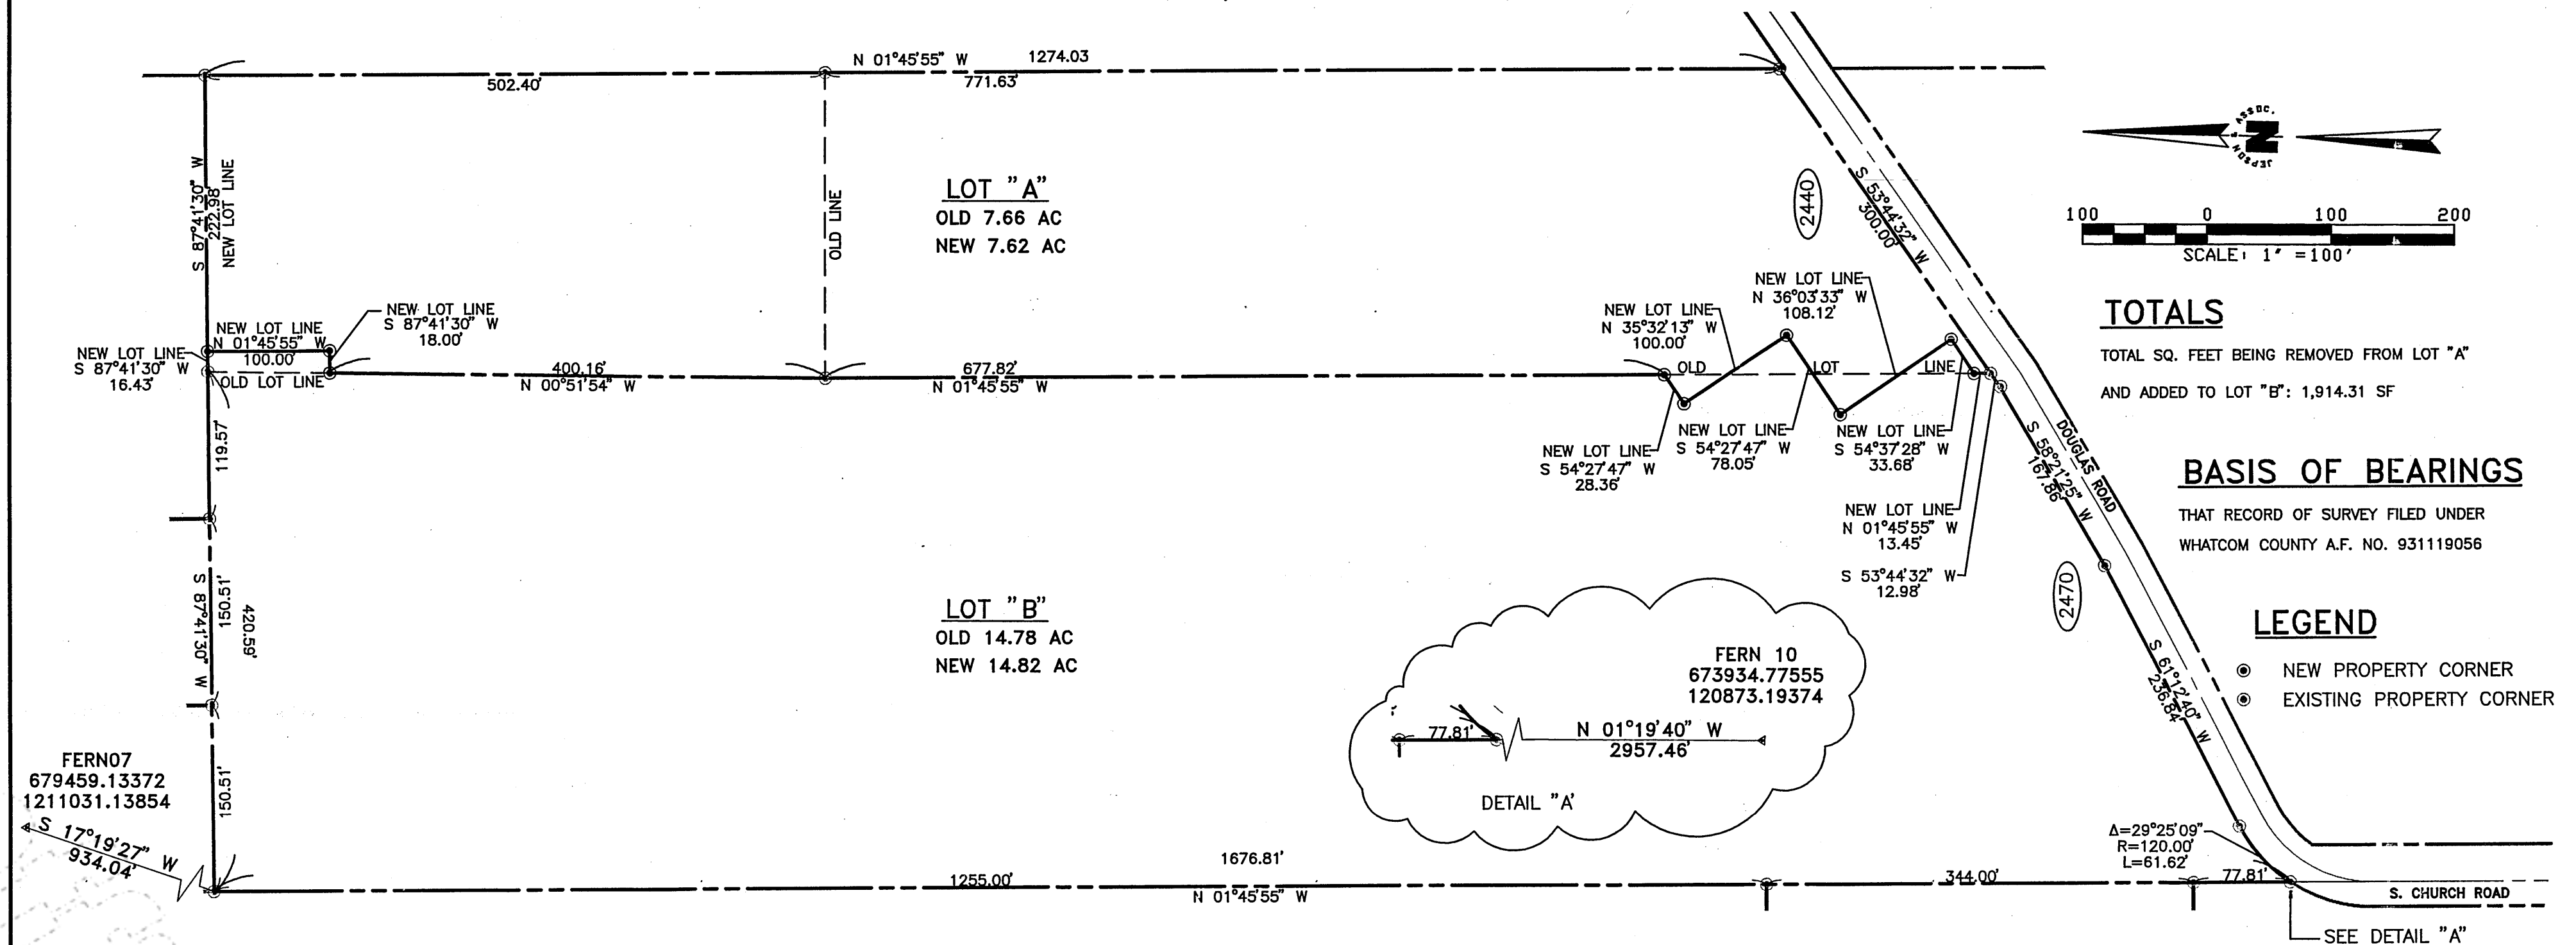


L:\Jepson Projects\2005\05055\dwg\PLANSHTS\LLA\LLA.DWG - blindman - JUL 20, 2007 - 08:24:25

2070801956

DOUGLAS ROAD LOT LINE ADJUSTMENT

A PORTION OF THE WEST 1/2 OF THE NW 1/4 OF SECTION 30 TOWNSHIP 39 NORTH, RANGE 2E OF W.M.
CITY OF FERNDALE, WHATCOM COUNTY, WASHINGTON

LEGAL DESCRIPTION

EXISTING PARCEL "A"

THAT PORTION OF THE WEST HALF OF THE NORTHWEST QUARTER OF SECTION 30, TOWNSHIP 39 NORTH, RANGE 2 EAST OF W.M., WHATCOM COUNTY, WASHINGTON, DESCRIBED AS FOLLOWS:

COMMENCING AT THE SOUTHWEST CORNER OF SAID NORTHWEST QUARTER OF SECTION 30; THENCE NORTH 01°45'55" WEST ALONG THE WEST LINE OF SAID SUBDIVISION A DISTANCE OF 1980.00 FEET (30 CHAINS); THENCE NORTH 87°41'30" EAST PARALLEL TO THE SOUTH LINE OF SAID NORTHWEST QUARTER A DISTANCE OF 420.59 FEET TO THE POINT OF BEGINNING; THENCE CONTINUING NORTH 87°41'30" EAST A DISTANCE OF 239.41 FEET; THENCE SOUTH 01°45'55" EAST PARALLEL TO THE WEST LINE OF SAID NORTHWEST QUARTER A DISTANCE OF 502.40 FEET TO THE NORTHEAST CORNER OF THAT TRACT OF LAND DESCRIBED UNDER WHATCOM COUNTY AUDITOR'S FILE NO. 1525469; THENCE SOUTH 88°14'05" WEST ALONG THE NORTH LINE OF SAID TRACT A DISTANCE OF 247.26 FEET TO THE NORTHWEST CORNER OF SAID TRACT; THENCE NORTH 00°51'54" WEST 500.19 FEET TO THE POINT OF BEGINNING.

AND

COMMENCING AT THE NORTHWEST CORNER OF THE SOUTHWEST QUARTER OF SECTION 30, TOWNSHIP 39 NORTH, RANGE 2 EAST OF W.M.; THENCE SOUTH 89°29'12" EAST ALONG THE EAST, WEST CENTERLINE OF SAID SECTION 30 A DISTANCE OF 660.03 FEET; THENCE NORTH 01°03'15" EAST PARALLEL TO THE WEST LINE OF THE NORTHWEST QUARTER OF SAID SECTION 30 A DISTANCE OF 681.70 FEET TO THE POINT OF BEGINNING, ALSO BEING ON THE AS BUILT CENTERLINE OF COUNTY ROAD NO. 21 COMMONLY KNOWN AS DOUGLAS ROAD; THENCE CONTINUING NORTH 01°03'15" EAST A DISTANCE OF 795.90 FEET; THENCE NORTH 88°56'45" WEST, AT RIGHT ANGLE A DISTANCE OF 247.26 FEET; THENCE SOUTH 01°03'15" WEST OF RIGHT ANGLE PARALLEL TO THE WEST LINE OF THE NORTHWEST QUARTER OF SAID SECTION 30 A DISTANCE OF 965.79 FEET TO THE AS BUILT CENTERLINE OF SAID COUNTY ROAD NO. 21; THENCE NORTH 56°33'44" EAST ALONG SAID CENTERLINE A DISTANCE OF 300.00 FEET TO THE POINT OF BEGINNING.

SHEET 2 OF 2

LEGAL DESCRIPTION CONTINUED

EXISTING PARCEL "B"

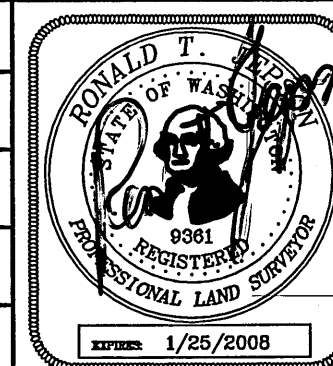
THAT PORTION OF THE WEST HALF OF THE NORTHWEST QUARTER OF SECTION 30, TOWNSHIP 39 NORTH, RANGE 2 EAST OF W.M., WHATCOM COUNTY, WASHINGTON, DESCRIBED AS FOLLOWS:

COMMENCING AT THE SOUTHWEST CORNER OF THE SAID NORTHWEST QUARTER OF SECTION 30; THENCE NORTH 01°45'55" WEST ALONG THE WEST LINE OF SAID SUBDIVISION, A DISTANCE OF 1980.00 FEET (30 CHAINS) TO THE POINT OF BEGINNING; THENCE NORTH 87°41'30" EAST PARALLEL TO THE SOUTH LINE OF SAID NORTHWEST QUARTER, A DISTANCE OF 420.59 FEET; THENCE SOUTH 00° 51'54" EAST 500.19 FEET TO THE NORTHWEST CORNER OF THE TRACT OF LAND DESCRIBED UNDER WHATCOM COUNTY AUDITOR'S FILE NO. 1525469; THENCE SOUTH 01°45'55" EAST ALONG THE WEST LINE OF SAID TRACT PARALLEL TO THE WEST LINE OF SAID NORTHWEST QUARTER A DISTANCE OF 965.79 FEET TO THE CENTER LINE OF DOUGLAS ROAD; THENCE SOUTH 58°21'25" WEST ALONG SAID CENTER LINE A DISTANCE OF 169.21 FEET; THENCE SOUTH 61°12'40" WEST ALONG SAID CENTER LINE A DISTANCE OF 237.34 FEET TO A CURVE TO THE LEFT HAVING RADIUS OF 100.00 FEET THE CENTER OF WHICH BEARS SOUTH 28°47'20" EAST; THENCE ALONG SAID CENTER LINE ON SAID CURVE THROUGH A CENTRAL ANGLE OF 62°58'35" AN ARC DISTANCE OF 109.91 FEET TO THE SAID WEST LINE OF THE NORTHWEST QUARTER; THENCE NORTH 01°45'55" WEST ALONG SAID WEST LINE A DISTANCE OF 1743.15 FEET TO THE POINT OF BEGINNING.

EXCEPT COUNTY ROAD;

SITUATE IN WHATCOM COUNTY, STATE OF WASHINGTON.

JOB # 05055

Scale
AS SHOWNDrawn by
B.J.H.DATE
05/15/07CHECKED BY
T.A.U.APP'D
R.T.J.

SEC. 30 ,TWP. 39, N., RNG. 2E., W.M.

RONALD T. JEPSON & ASSOCIATES
CONSULTING ENGINEERS • LAND SURVEYORS • PROJECT MGMT. & DEV.
222 GRAND AVE. SUITE 'C', PH. * 360.733.5760, FAX * 360.641.8939,
E-MAIL JEPSON222@AOL.COM, BELLINGHAM, WASHINGTON 98225

L:\Jepson Projects\2005\05055\dwg\PLANS\HITS\LLA\LLA.DWG - blindman - JUL 20, 2007 - 08:24:41